


LEGEND

- W—W— New 1500 mPVC Class 16 Water Main
- -W- - - Existing Water Main
- Fire Hydrant
- W—W—C Water Service Connection
- ⊙ Water Kerb Marker
- - - - - Service Sleeve
- Kerb & Channel
- Site Boundary
- ① Tapping Band
- ② Gibault

IMPORTANT NOTE

- This plan was prepared for the sole purposes of the client for the specific purpose of recording the infrastructure for Whitsunday Regional Council. This plan is strictly limited to the Purpose and does not apply directly or indirectly and will not be used for any other application, purpose, use or matter. The plan is presented without the assumption of a duty of care to any other person (other than the Client) ("Third Party") and may not be relied on by Third Party.
- RPS Australia East Pty Ltd will not be liable (in negligence or otherwise) for any direct or indirect loss, damage, liability or claim arising out of or incidental to:
 - a Third Party publishing, using or relying on the plan;
 - RPS Australia East Pty Ltd relying on information provided to it by the Client or a Third Party where the information is incorrect, incomplete, inaccurate, out-of-date or unreasonable;
 - any inaccuracies or other faults with information or data sourced from a Third Party;
 - RPS Australia East Pty Ltd relying on surface indicators that are incorrect or inaccurate;
 - the Client or any Third Party not verifying information in this plan where recommended by RPS Australia East Pty Ltd;
 - lodgment of this plan with any local authority against the recommendation of RPS Australia East Pty Ltd;
 - the accuracy, reliability, suitability or completeness of any approximations or estimates made or referred to by RPS Australia East Pty Ltd in this plan.
- Without limiting paragraph 1 or 2 above, this plan may not be copied, distributed, or reproduced by any process unless this note is clearly displayed on the plan.
- Scale shown is correct for the original plan and any copies of this plan should be verified by checking against the bar scale.
- Stop valves, hydrants and other visible surface indicators have been located by survey. Other information has been obtained from design and construction information [provided by Third Parties] and should be checked before use.
- CCAD Ref: 3424 Stage 10D ASCON.

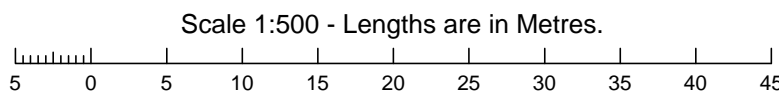

						Surveyed by	JD	Horizontal Datum	MGA Vdie RTK GPS	Client	East Coast Civil Pty Ltd	Title	As Constructed Survey Water Reticulation Twin Creek Court, Cannonvale				
						Survey Date	10/05/2013										
						Drawn by	AD	Level Datum	AHD Vide OPM 102470 RL= 40.715	Project	Whitsunday Lakes Stage 10D						
						Checked by	SR										
						CCAD	See Note										
						Parish	Dryander	County	Herbert								
						Locality	Cannonvale	Local Authority	Whitsunday Regional								
	A	Original Issue	29/05/2013	SR										Scale 1:500 @ A1	Job Ref	Drawing No	Rev
	Rev.		Description	Date	Appr.									Date 29/05/2013	110861-3	ASCON-02	A
													© COPYRIGHT PROTECTS THIS PLAN Unauthorised reproduction or amendment not permitted. Please contact the author.				
												RPS Australia East Pty Ltd ACN 140 292 762 ABN 44 140 292 762 Unit 1, 3 Carlo Drive Cannonvale QLD 4802 PO Box 943 Airlie Beach QLD 4802 T +61 7 4948 5300 F +61 7 4948 5301 W rpsgroup.com.au					